
**PITTSBURG UNIFIED SCHOOL DISTRICT
PUSD MARTIN LUTHER KING JR JUNIOR HIGH SCHOOL
RUNNING TRACK AND FIELD ALTERATIONS**

**BID ADDENDUM NO. 2
November 17, 2025**

PROJECT: **Martin Luther King Jr Junior High School Running Track & Field Alterations**
2012 Carion Court, Pittsburg, CA 94565

OWNER: Pittsburg Unified School District
3200 Loveridge Road, Pittsburg, CA 94565

Notice is hereby given to all prospective bidders that plans and specifications on the subject project are modified as hereinafter set forth. This Addendum shall be attached to and form a part of the plans and specifications. All bidders must acknowledge receipt of this addendum on the Bid Form. In case of difference with previous addenda or communications, this addendum takes precedence.

It is the responsibility of all bidders to notify all subcontractors from whom they request bids and from whom they accept bids of all changes contained in this addendum.

PROJECT MANUAL

1. Item No. PM-1

Reference: N/A
Attachment: Mandatory Pre-Bid Conference & Walkthrough Sign-In Sheet
Description: Pre-bid conference sign-in sheet

DRAWINGS

1. ITEM NO. 01

Reference: C2.01
Attachment: CSK-03 & CSK-04
Description: Replace specified "6in trench drain" with "4in ACO K100 trench drain,"
typical of all locations. Contractor shall provide a widened curb per
CSK-04 where trench drains installed along curved walkways.

2. ITEM NO. 02

Reference: A1.02
Attachment: N/A
Description: Omit Keynote 07 at existing drinking fountain to be replaced in
location with new hi-lo fountain and bottle filler.

3. ITEM NO. 03

Reference: IR1.0
Attachment: IR1.0, Irrigation Layout
Description: Existing irrigation at north west corner play field shall be replaced with
new.

RFI REPONSES:

- 1. Question/Issue:** Sheet A1.01, "Please confirm the process for removal of existing turf and prep for new sod / grass. Plan sheet A1.01 says to clear 8" of sod and topsoil, if this is the requirement, there will be a lot of cost associated with bringing in import topsoil. Furthermore, the north side of the field irrigation laterals and heads are to remain, if we strip 8" of grass and topsoil, we'll destroy all of the irrigation in that area. Please detail the process of grass removal, depth of import topsoil required, and amendment procedures for bid purposes if existing topsoil is to remain in place."

Response: Contractor shall replace irrigation in this zone per attached IR1.0 Irrigation Layout per Drawing Item No 02 above.
- 2. Question/Issue:** Sheet A1.02, "Please provide a detail for the proposed trench drain installation noted on A1.02 callout 07 at the drinking fountain."

Response: Omit Keynote 07 at existing drinking fountain to be replaced.
- 3. Question/Issue:** Sheet C2.01, "Please provide a detail for the 6" Trench Drains noted and depicted on Sheet C2.01."

Response: Trench drains shall be installed per manufacturer's recommendations per attached CSK-02 Trench Drain Detail.
- 4. Question/Issue:** Sheet C2.01, "Please provide a detail for the 6" Trench Drains noted and depicted on Sheet C2.01."

Response: Trench drains shall be installed per manufacturer's recommendations per attached CSK-02 Trench Drain Detail.
- 5. Question/Issue:** Sheet C3.01, "Please provide a detail for the AC Pathway that depicts the sectional depths and edge conditions."

Response: Please see attached CSK-01 for asphalt paving section, and ASK-02 for typical edge condition at landscaping.
- 6. Question/Issue:** Sheet C0.02, "Per notes on C0.02 construction fencing around the site shall have green wind screen. Because we will use the existing fencing as the construction fencing, are we required to place green screen on it?"

Response: Wind screen shall be provided between play field and campus areas per attached ASK-01.
- 7. Question/Issue:** Sheet IR1.0, "The irrigation legend indicates that mainline shall be schedule 40 PVC. However, specification section 32 84 00/ Part 2 indicates that mainline 3" & larger shall be class 200 PVC and 2-1/2" & smaller shall be schedule 40 PVC - (mainline shown on irrigation plan is 3" size). Please clarify"

Response: Plans have been updated to state that the mainline is to remain and protected in place. (AB-SEE REV IR1.0 REV 11102025).

- 8. Question/Issue:** Sheet IR1.0, "The irrigation legend indicates that lateral line shall be PVC class 200. However, specification section 32 84 00/ Part 2 indicates that lateral line 1/2" shall be 315 PVC plastic pipe, 3/4" & larger shall be schedule 40 PVC plastic pipe. Please clarify."
- Response:** All new lateral line pipe shall be installed as class 200 unless otherwise notified by the school district.
- 9. Question/Issue:** Sheet IR1.0, "The irrigation legend indicates a symbol of new mainline. However, there is a callout on the right side of the grass field area near the basketball court that identifies an existing mainline and wire. Please clarify."
- Response:** Plans have been updated to state that the mainline is to remain and protected in place. If any mainline is damaged during construction all mainline is to be replaced with the exact pipe type and size as that what was damaged (AB-SEE REV IR1.0 REV 11102025).
- 10. Question/Issue:** Sheet IR1.0, "Remote control vale B.6 is a new valve. However, there is a callout "existing valves. Protect in place" that is shown for remote control valve B6. Please clarify."
- Response:** All valves (and wires) shown are existing and drafted from as built plan set and shall remain in place and protected during construction. If any valve is damaged during construction valve is to be replaced with the exact valve type and size as that what was damaged (AB-SEE REV IR1.0 REV 11102025).
- 11. Question/Issue:** Sheet IR1.0, "There is a callout stating: "Cap any unused valves and disconnect wire from controller". Please confirm whether valves B.2, B.3, B.4, B.5, B.15, B.16, B.17, B.18, B.19, B.22, B.26, B.27, and B.28 are existing valves or new valves."
- Response:** All valves (and wires) shown are existing and drafted from as built plan set and shall remain in place and protected during construction. If any valve is damaged during construction valve is to be replaced with the exact valve type and size as that what was damaged (AB-SEE REV IR1.0 REV 11102025).
- 12. Question/Issue:** Sheet IR1.0, "How many stations are there of the existing irrigation controller?"
- Response:** ALL Valves are existing and are to be protected during construction and remain in place, no new valves are added to the project.
- 13. Question/Issue:** Sheet IR1.0, "Please confirm the hydroseed area at the west side of the basketball court is irrigated by the existing irrigation system"
- Response:** Contractor shall replace irrigation in this zone per attached IR1.0 Irrigation Layout per Drawing Item No 02 above.
- 14. Question/Issue:** Sheet IR1.0, "What is the water source of the irrigation system (reclaimed or domestic)?"
- Response:** Irrigation system water source shall be domestic.

15. Question/Issue: Sheet IR1.0, "Please confirm that all irrigation valves are in operable condition and that any valves damaged or inoperable prior to construction will be paid for as a change order?"

Response: Contractor shall assume all existing irrigation valves are in operable condition.

END OF BID ADDENDUM ITEMS


ATTACHMENTS:

Project Manual:

- **Mandatory Pre-Bid Conference & Walkthrough Sign-In Sheet**
- **Section 00 01 10 Table of Contents**
- **Section 00 01 20 List of Schedules**
- **Section 00 11 16 Notice to Bidders**
- **Section 32 84 00 Planting Irrigation**
- **Section 32 93 00 Planting**



Project Drawings:

- **IR1.0 – Irrigation Layout**
- **ASK01 – Limits of Wind Screening at Fencing**
- **ASK02 – Asphalt Paving Edge at Landscape**
- **CSK-01 – Asphalt Section**
- **CSK-02 – Manufacturer's Trench Drain Detail**
- **CSK-03 – Trench Drain Callout**
- **CSK-04 – Trench Drain Callout**

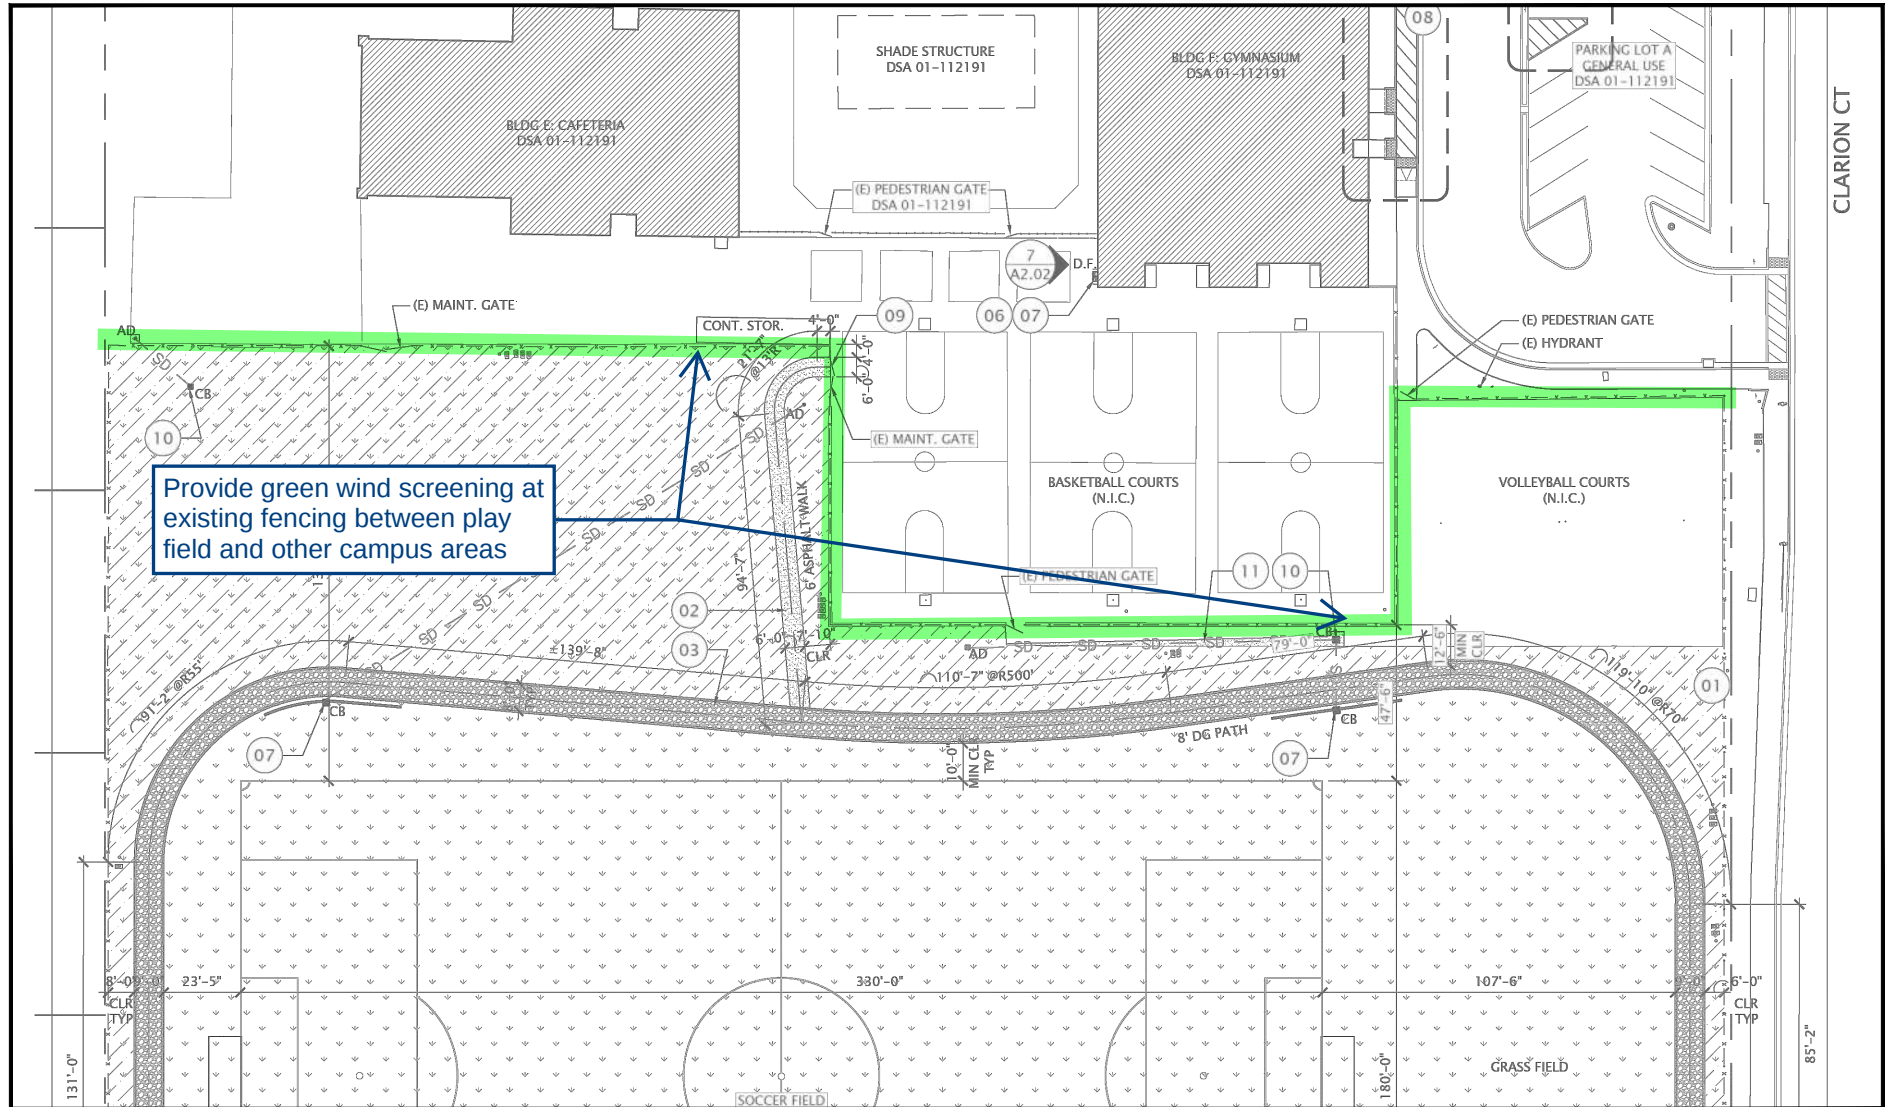

DRAWING TITLE: LIMITS OF WIND SCREENING AT FENCING
REFERENCE DRAWING: A1.02
ISSUED VIA: ADDENDUM 02 (11/14/25)
SCALE: N.T.S.

ASK-01

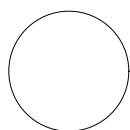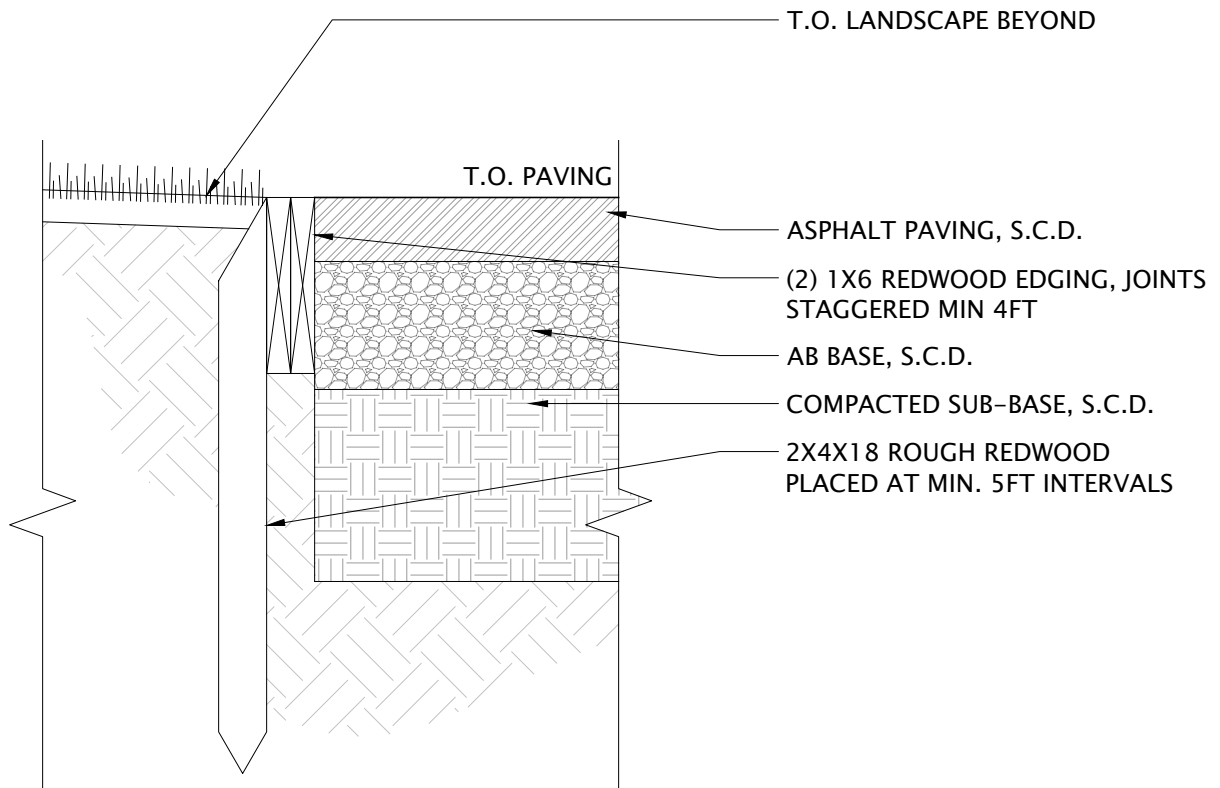



ASPHALT EDGE AT LANDSCAPE

ac-landscape-edge.dwg

SCALE: 2" = 1'-0"

DRAWING TITLE: ASPHALT PAVING EDGE AT LANDSCAPE
REFERENCE DRAWING: A1.02
ISSUED VIA: ADDENDUM 02 (11/17/25)
SCALE: 2"=1'-0"

ASK-02

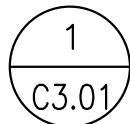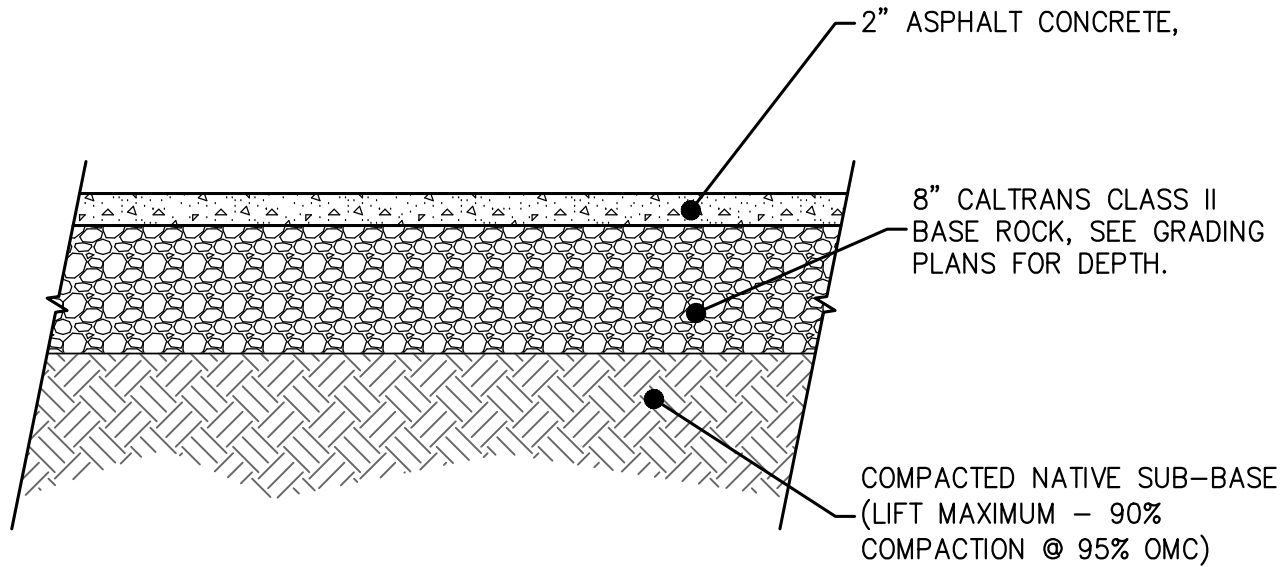

ASPHALT SECTION

NTS


DRAWING TITLE: ASPHALT SECTION DEPTHS
REFERENCE DRAWING: C3.01
ISSUED VIA: ADDENDUM 02 (11/14/25)
SCALE: N.T.S.

CSK-01

PLUM | architects

870 Market Street, Ste 878, San Francisco CA
94102
TEL: 415-837-0900

Martin Luther King Jr Junior High School
Running Track & Field Alterations Project
Pittsburg Unified School District
DSA Appl.#: 01-122476, Bid: 26-001

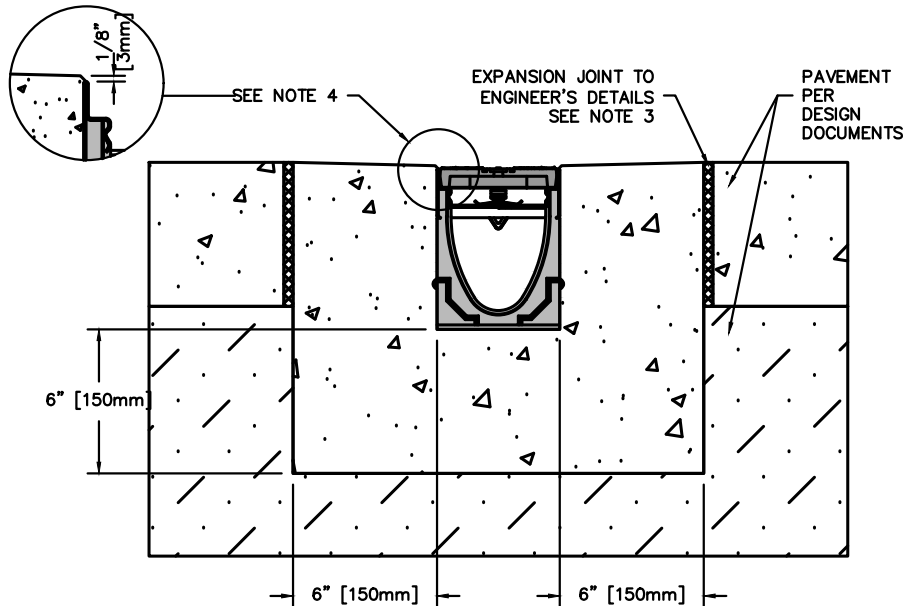

NOTES:

1. IT IS NECESSARY TO ENSURE MINIMUM DIMENSIONS SHOWN ARE SUITABLE FOR EXISTING GROUND CONDITIONS.
ENGINEERING ADVICE MAY BE REQUIRED.
2. MINIMUM CONCRETE STRENGTH OF 4,000 PSI IS RECOMMENDED. CONCRETE SHOULD BE VIBRATED TO ELIMINATE AIR POCKETS.
3. EXPANSION AND CONTRACTION CONTROL JOINTS AND REINFORCEMENT ARE RECOMMENDED TO PROTECT CHANNEL AND CONCRETE SURROUND. *ENGINEERING ADVICE MAY BE REQUIRED.*
4. THE FINISHED LEVEL OF THE CONCRETE SURROUND MUST BE APPROX. 1/8" [3mm] ABOVE THE TOP OF THE CHANNEL EDGE. ENSURE ADA COMPLIANT COVER.
5. CONCRETE BASE THICKNESS SHOULD MATCH SLAB THICKNESS. ENGINEERING ADVICE MAY BE REQUIRED TO DETERMINE PROPER LOAD CLASS.
6. REFER TO ACO'S LATEST INSTALLATION INSTRUCTIONS FOR FURTHER DETAILS.

K100 KLASSIKDRAIN - LOAD CLASS C PROVIDE TRAFFIC RATED AND ADA COMPLIANT GRATE OVER TRENCH DRAIN

GENERAL

THE SURFACE DRAINAGE SYSTEM SHALL BE POLYMER CONCRETE K100 CHANNEL SYSTEM WITH GALVANIZED STEEL EDGE RAILS AS MANUFACTURED BY ACO POLYMER PRODUCTS, INC.

MATERIALS

CHANNELS SHALL BE MANUFACTURED FROM POLYESTER RESIN POLYMER CONCRETE WITH AN INTEGRALLY CAST-IN GALVANIZED STEEL EDGE RAIL. MINIMUM PROPERTIES OF POLYMER CONCRETE WILL BE AS FOLLOWS:
BE AS FOLLOWS:
COMPRESSIVE STRENGTH: 14,000 PSI
FLEXURAL STRENGTH: 4,000 PSI
TENSILE STRENGTH: 1,500 PSI
WATER ABSORPTION: 0.07%
FROST PROOF YES
DILUTE ACID AND ALKALI RESISTANT YES
B117 SALT SPRAY TEST COMPLIANT YES
THE SYSTEM SHALL BE 4" (100mm) NOMINAL INTERNAL WIDTH WITH A 5.1" (130mm) OVERALL WIDTH AND A BUILT-IN SLOPE OF 0.5%. CHANNEL INVERT SHALL HAVE DEVELOPED 'V' SHAPE. ALL CHANNELS SHALL BE INTERLOCKING WITH A MALE/FEMALE JOINT.

THE COMPLETE DRAINAGE SYSTEM SHALL BE BY ACO POLYMER PRODUCTS, INC. ANY DEVIATION OR PARTIAL SYSTEM DESIGN AND/OR IMPROPER INSTALLATION WILL VOID ANY AND ALL WARRANTIES PROVIDED BY ACO POLYMER PRODUCTS, INC.

CHANNEL SHALL WITHSTAND LOADING TO PROPER LOAD CLASS AS OUTLINED BY EN 1433. GRATE TYPE SHALL BE APPROPRIATE TO MEET THE SYSTEM LOAD CLASS SPECIFIED AND INTENDED APPLICATION. GRATES SHALL BE SECURED USING 'QUICKLOK' BOLTLESS LOCKING SYSTEM. CHANNEL AND GRATE SHALL BE CERTIFIED TO MEET THE SPECIFIED EN 1433 LOAD CLASS. THE SYSTEM SHALL BE INSTALLED IN ACCORDANCE WITH THE MANUFACTURER'S INSTRUCTIONS AND RECOMMENDATIONS.

DRAWING TITLE: TRENCH DRAIN DETAIL
REFERENCE DRAWING: C3.01
ISSUED VIA: ADDENDUM 02 (11/14/25)
SCALE: N.T.S.

CAD FILE: N/A


CSK-02

PLUM JOB NO: 2508

PLUM | architects


870 Market Street, Ste 878, San Francisco CA
94102
TEL: 415-837-0900

Martin Luther King Jr Junior High School
Running Track & Field Alterations Project
Pittsburg Unified School District
DSA Appl.#: 01-122476, Bid: 26-001

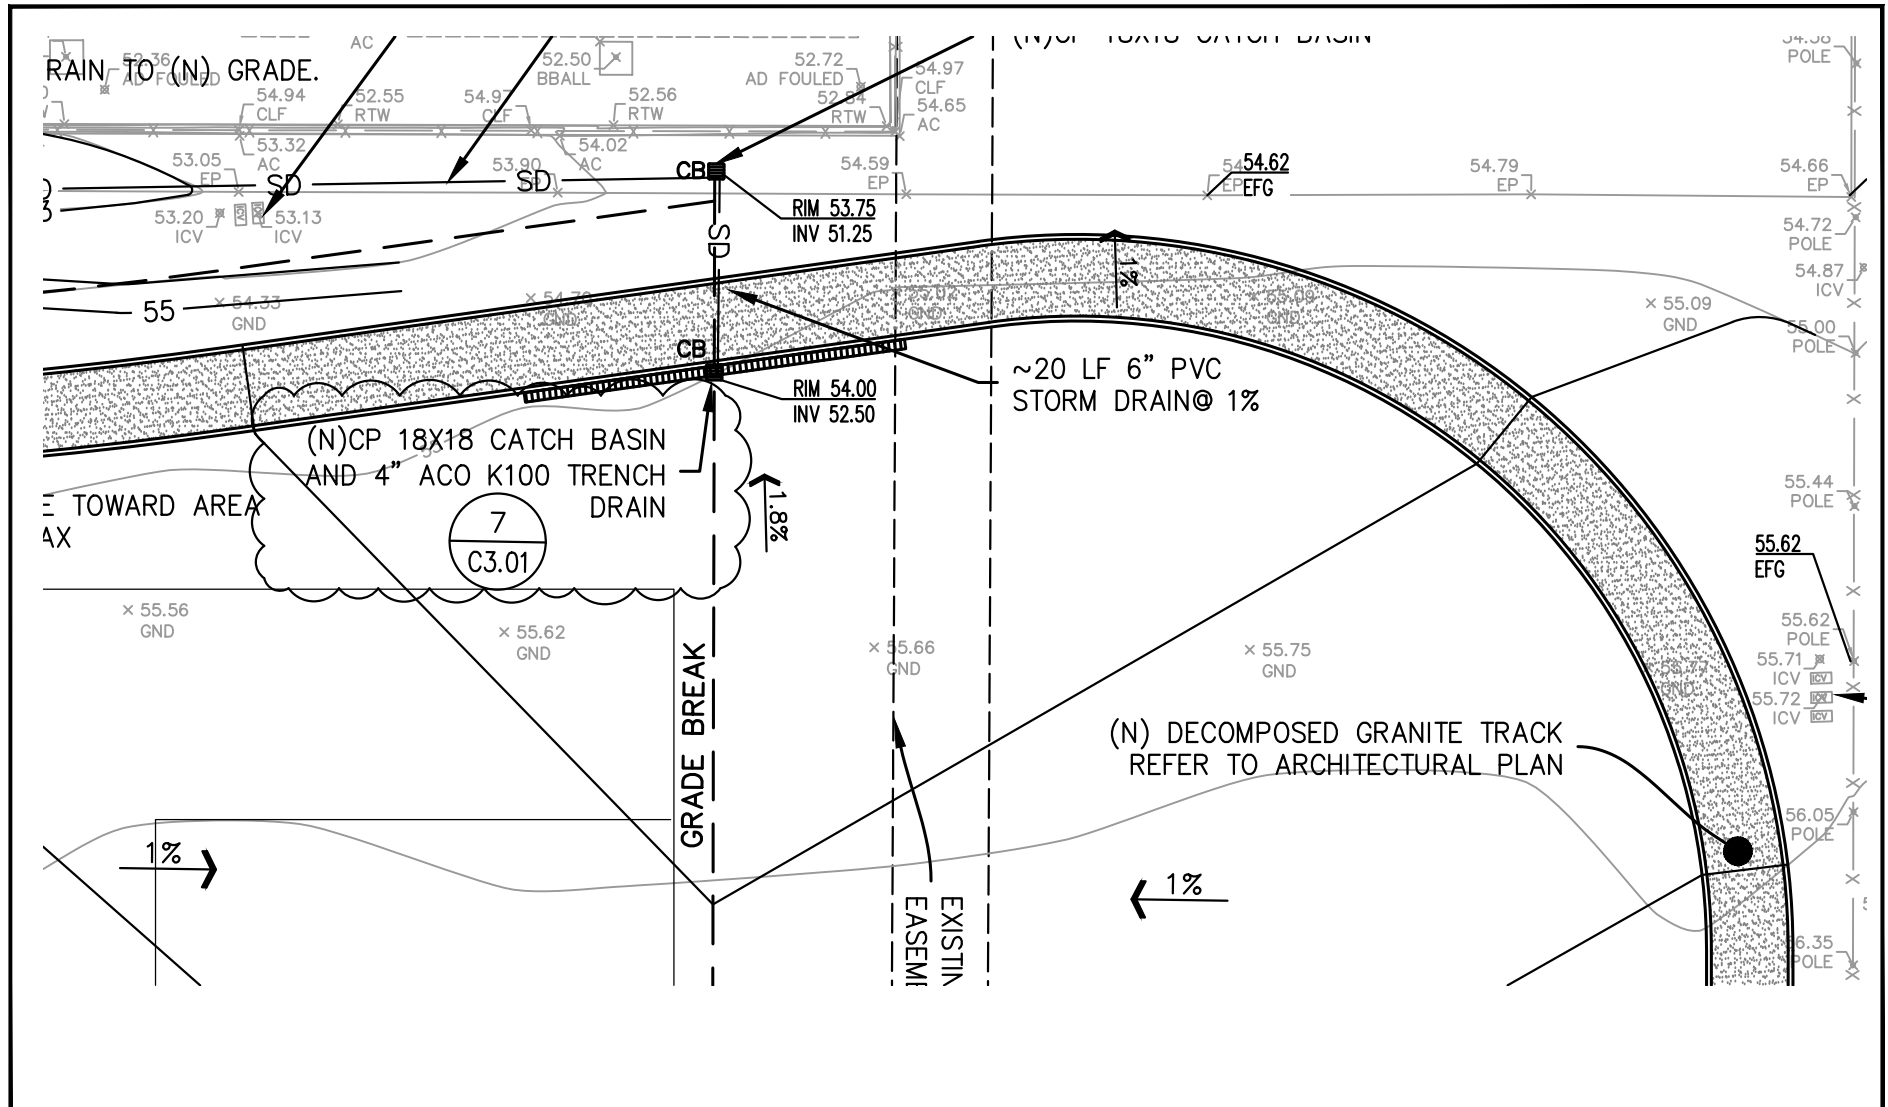

DRAWING TITLE: TRENCH DRAIN CALLOUT
REFERENCE DRAWING: C2.01
ISSUED VIA: ADDENDUM 02 (11/14/25)
SCALE: N.T.S.

CSK-03

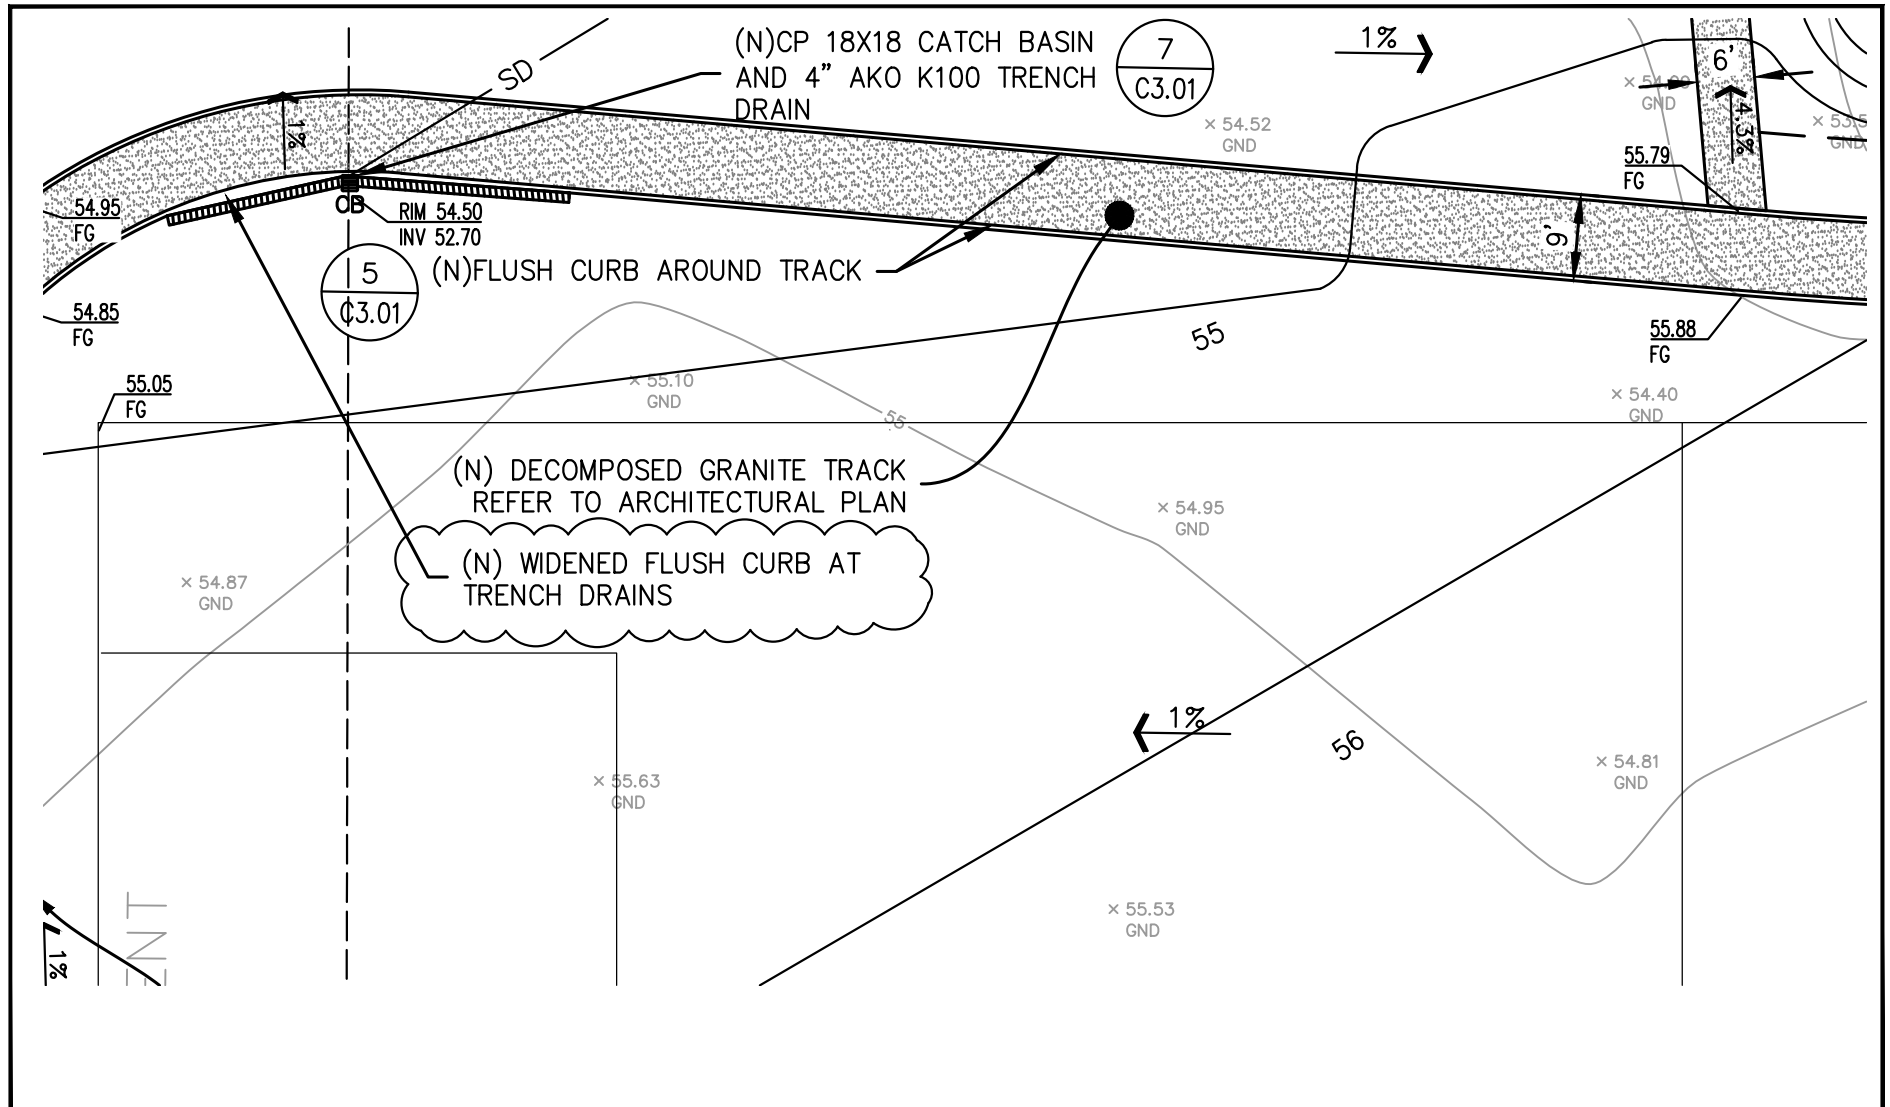

DRAWING TITLE: TRENCH DRAIN CALLOUT
REFERENCE DRAWING: C2.01
ISSUED VIA: ADDENDUM 02 (11/14/25)
SCALE: N.T.S.

CS/K-04